




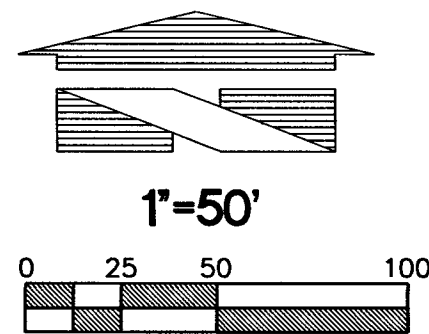


RECORD DRAWING

PUBLIC SANITARY SEWER EXTENSION PLAN AND PROFILE
CREEKSIDE VILLAGE
PORTIONS OF THE NW 1/4, AND THE NE 1/4, SECTION 26, TOWNSHIP 19 NORTH, RANGE EAST, W.M.
CITY OF DUPONT, PIERCE COUNTY, STATE OF WASHINGTON
(AS-BUILT)

SWLE No. 721730

APPROVED	AS-BUILT ACCEPTED	Date
WASTEWATER UTILITY MANAGER		DATE
PLAN APPROVAL EXPIRES ONE (1) YEAR FROM DATE OF APPROVAL.		

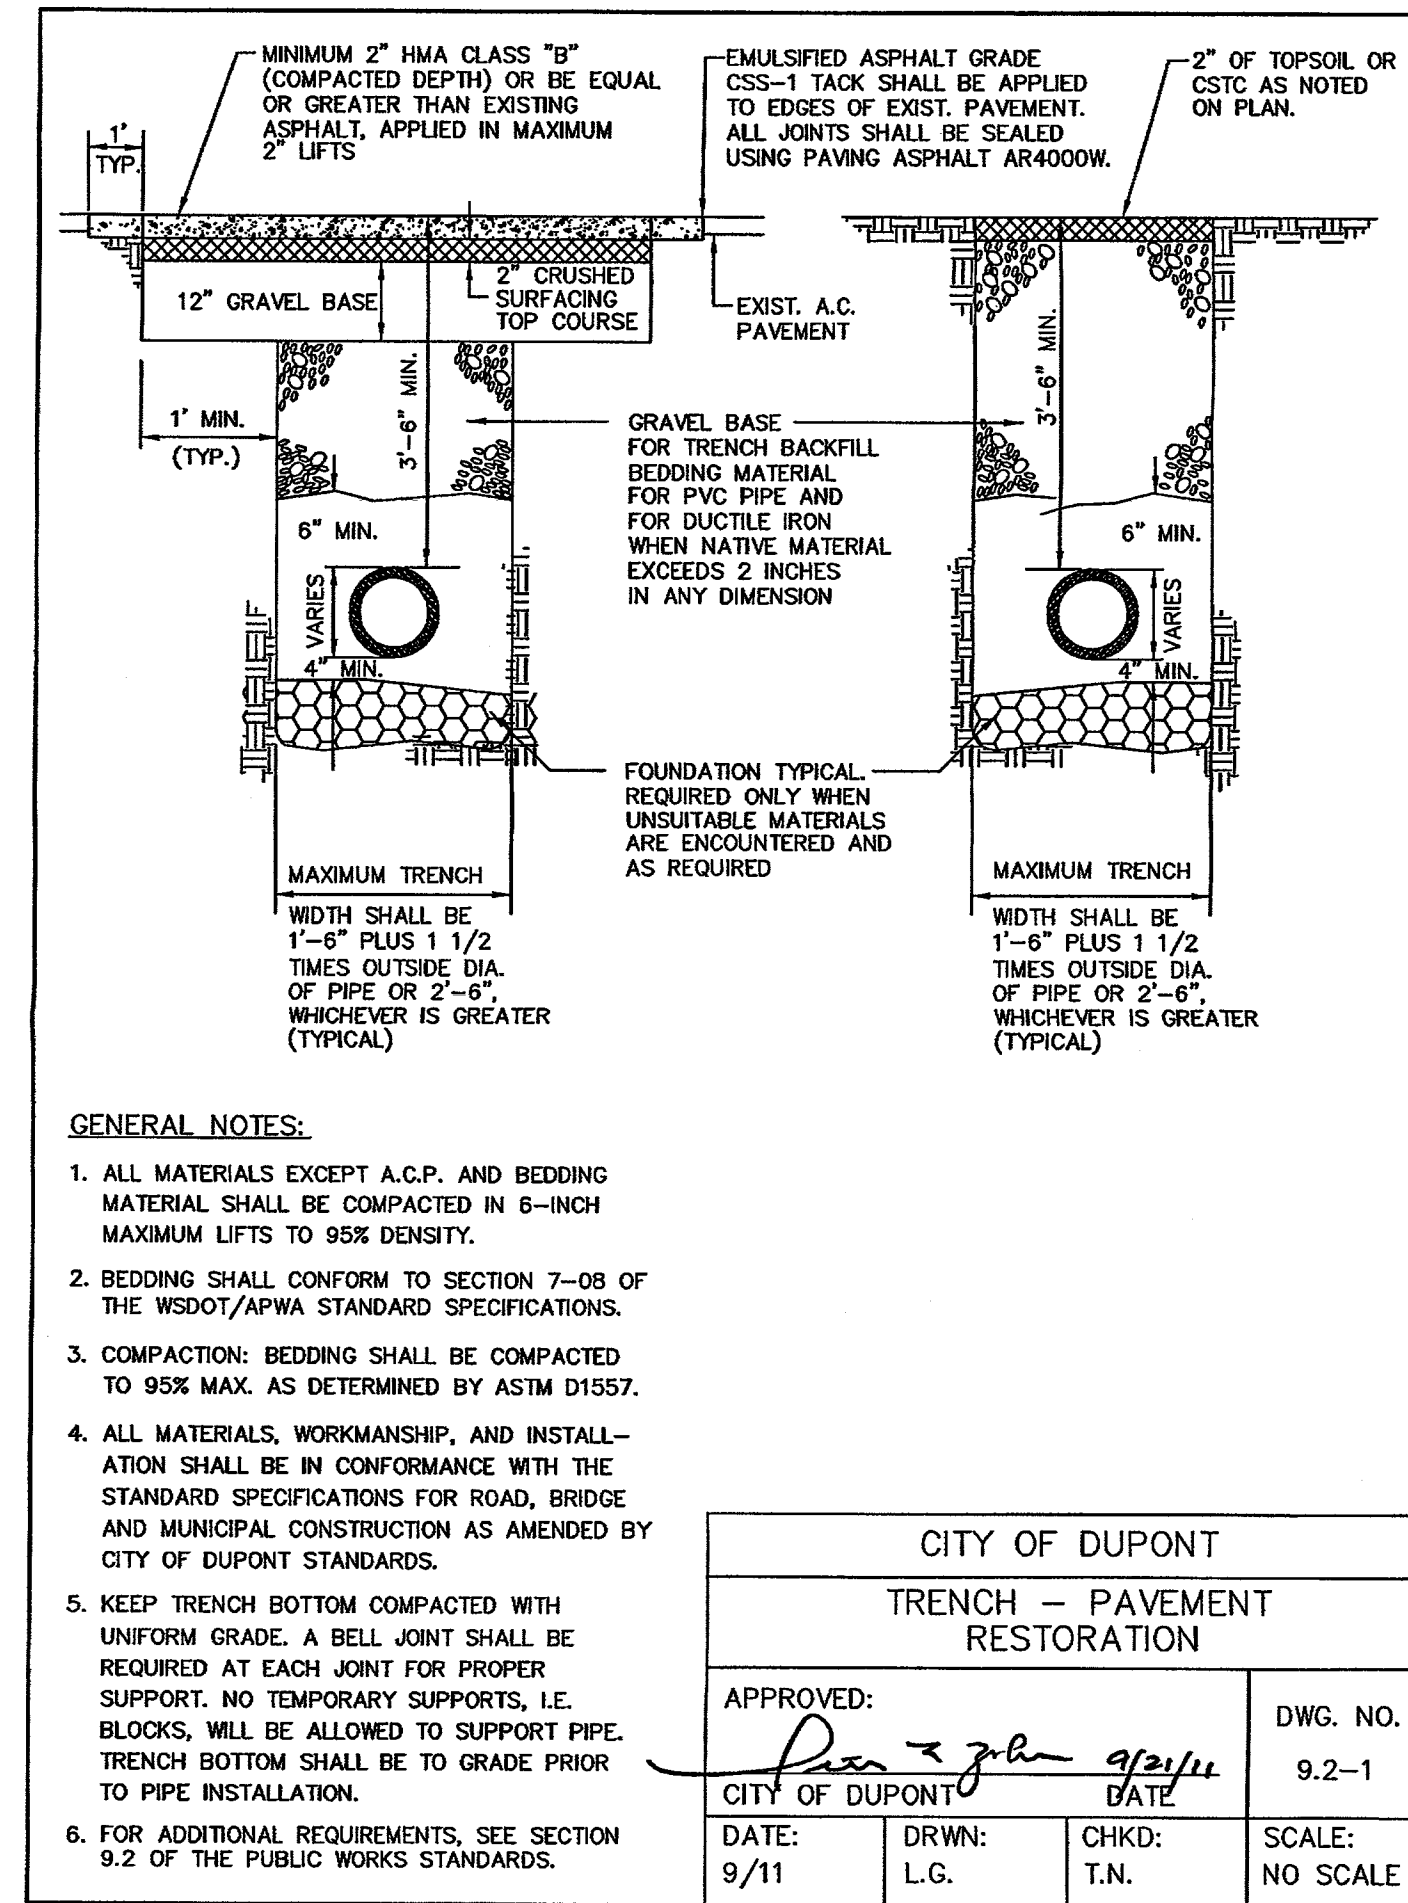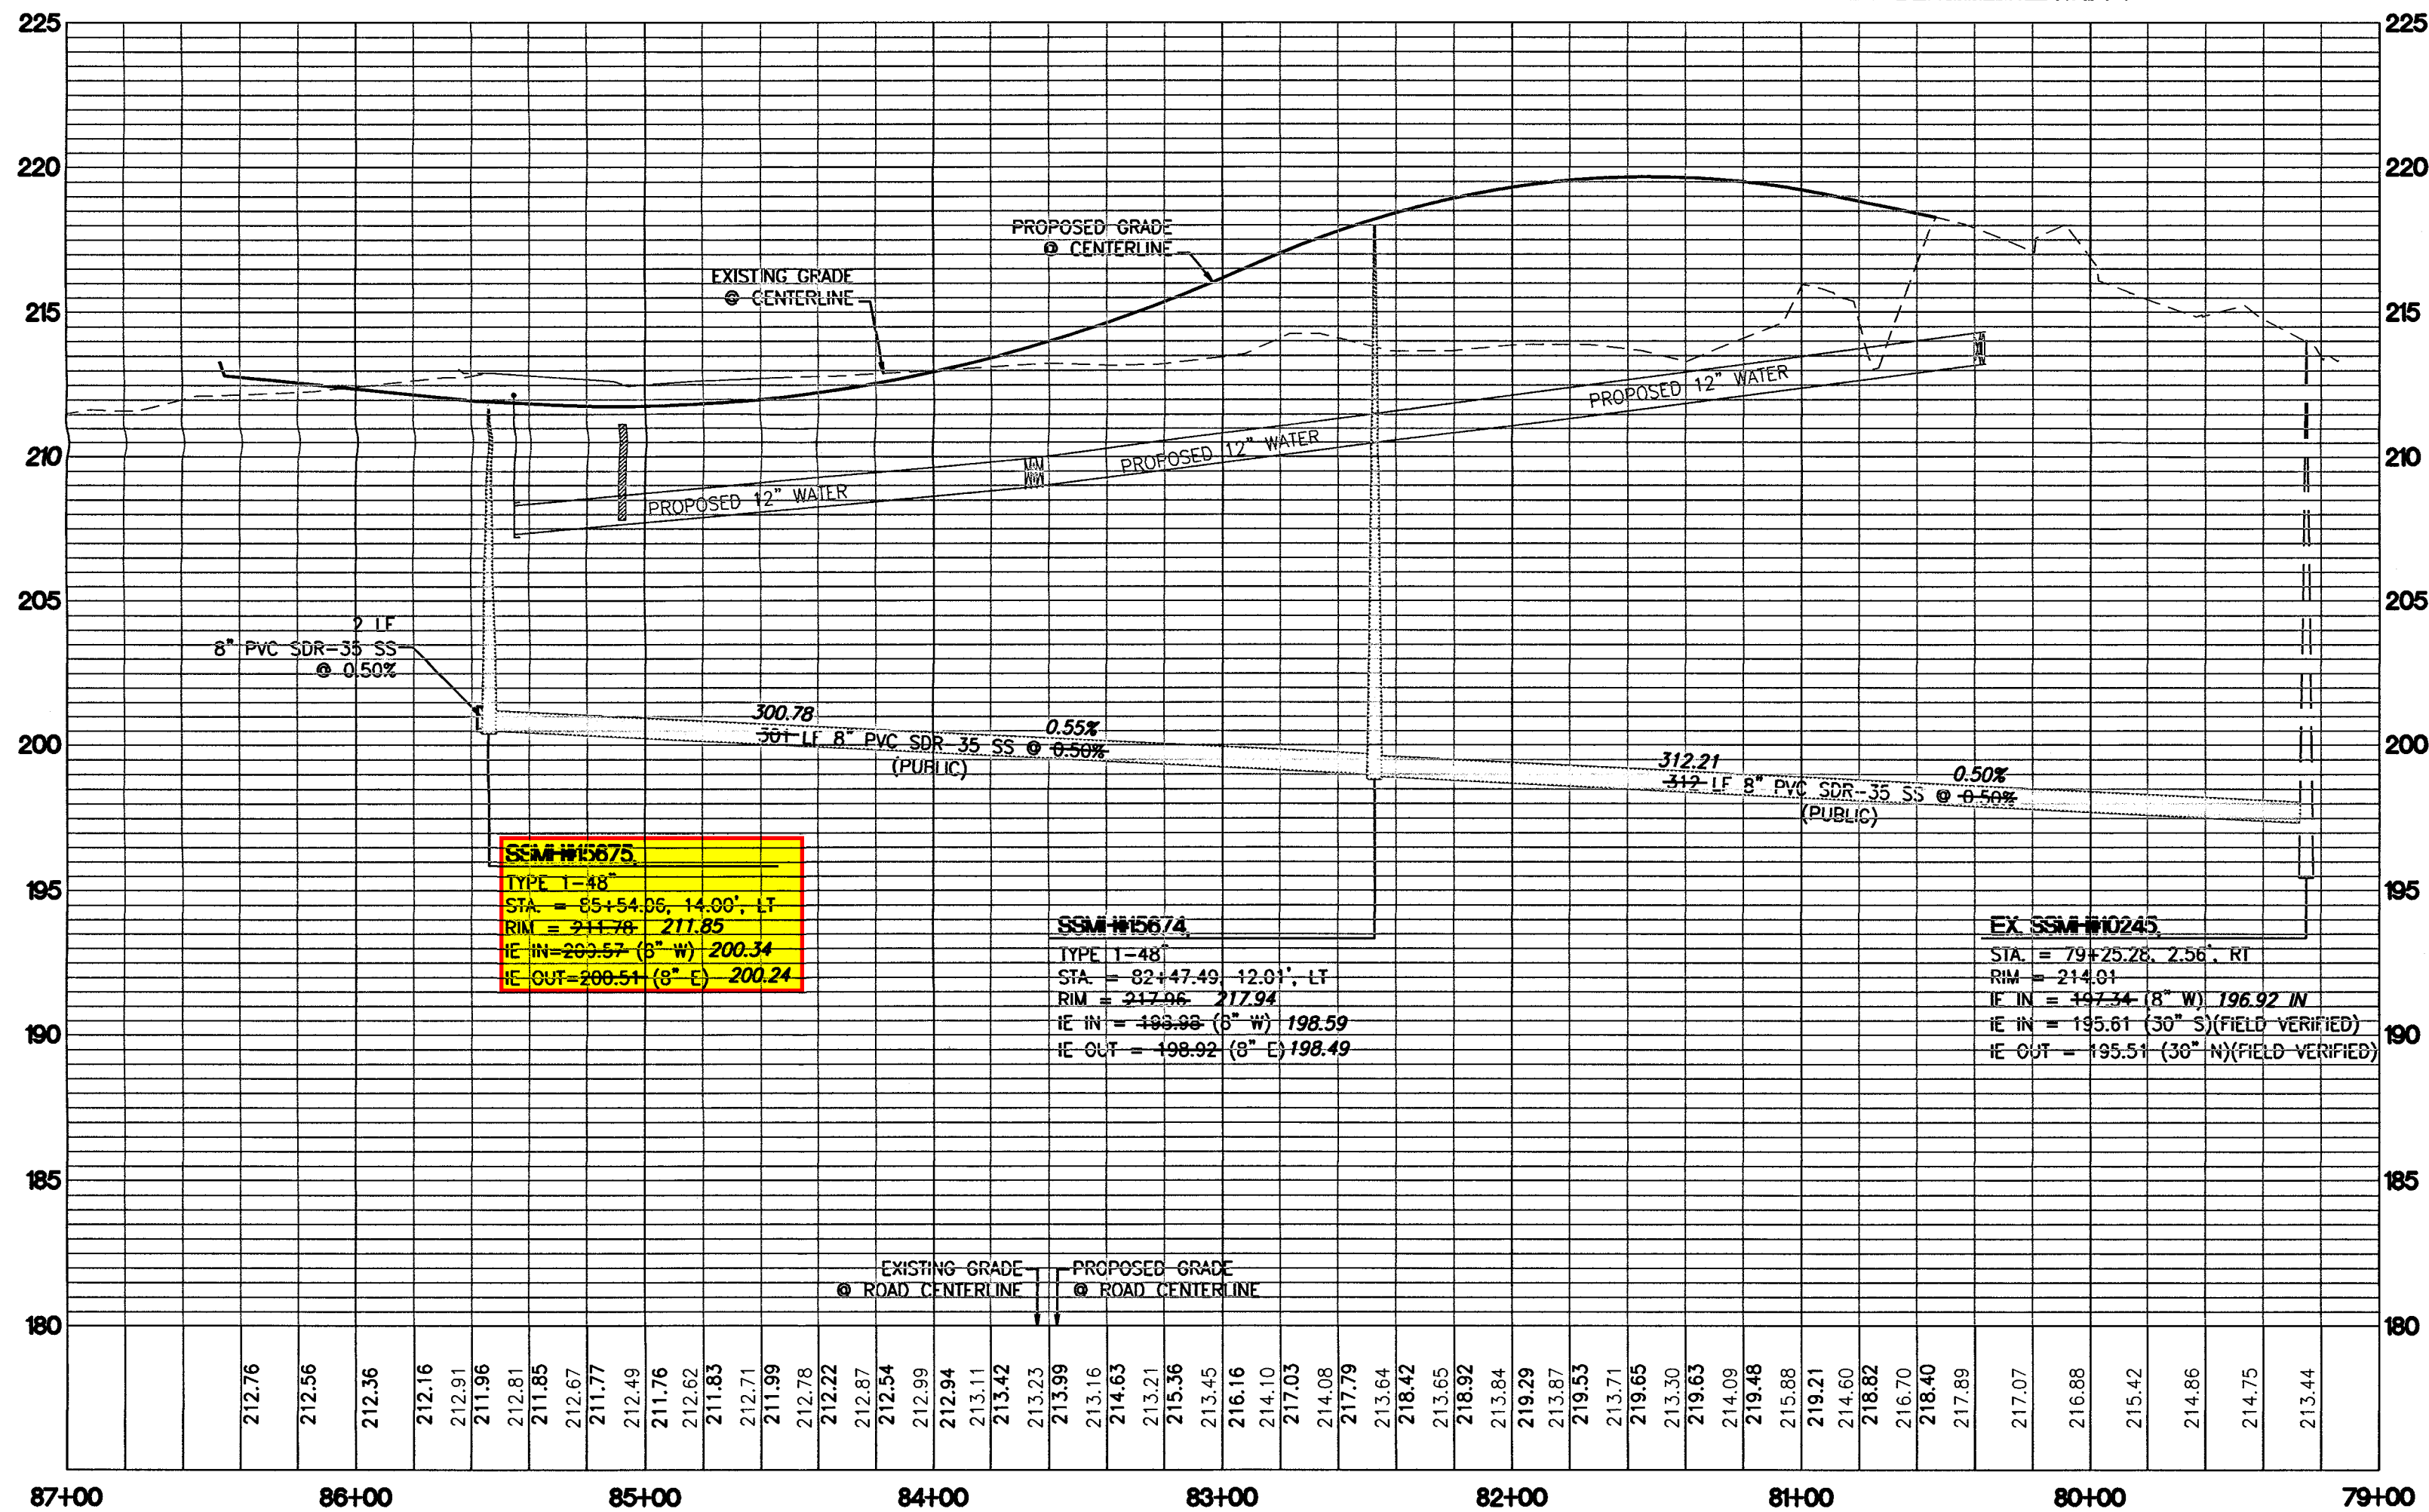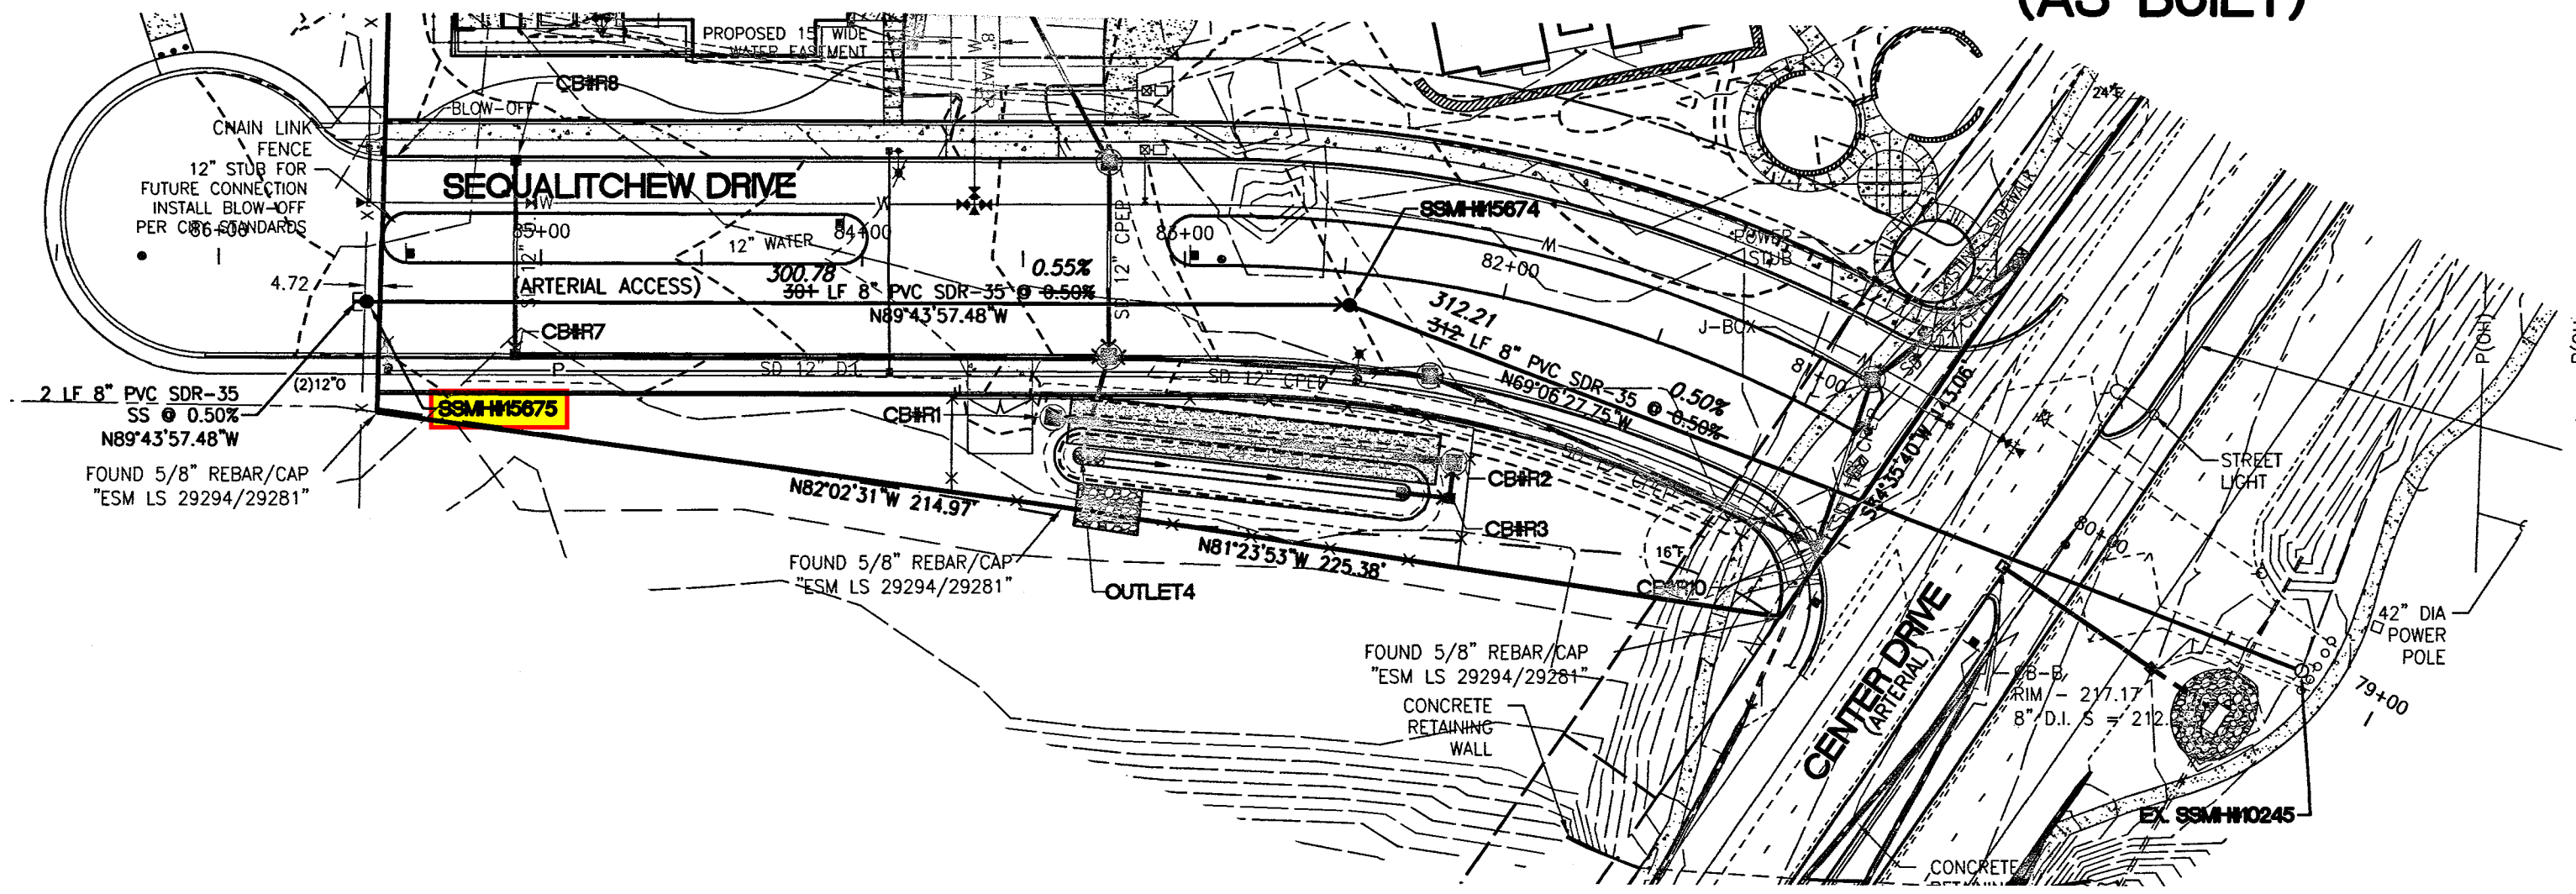

GENERAL NOTES:

- ALL MATERIALS EXCEPT A.C.P. AND BEDDING MATERIAL SHALL BE COMPACTED IN 6-INCH MAXIMUM LIFTS TO 95% DENSITY.
- BEDDING SHALL CONFORM TO SECTION 7-08 OF THE WSDOT/APWA STANDARD SPECIFICATIONS.
- COMPACTION: BEDDING SHALL BE COMPACTED TO 95% MAX. AS DETERMINED BY ASTM D1557.
- ALL MATERIALS, WORKMANSHIP, AND INSTALLATION SHALL BE IN CONFORMANCE WITH THE STANDARD SPECIFICATIONS FOR ROAD, BRIDGE AND MUNICIPAL CONSTRUCTION AS AMENDED BY CITY OF DUPONT STANDARDS.
- KEEP TRENCH BOTTOM COMPACTED WITH UNIFORM GRADE. A BELL JOINT SHALL BE REQUIRED AT EACH JOINT FOR PROPER SUPPORT. NO TEMPORARY SUPPORTS, I.E. BLOCKS, WILL BE ALLOWED TO SUPPORT PIPE. TRENCH BOTTOM SHALL BE TO GRADE PRIOR TO PIPE INSTALLATION.
- FOR ADDITIONAL REQUIREMENTS, SEE SECTION 9.2 OF THE PUBLIC WORKS STANDARDS.



CITY OF DUPONT			
TRENCH - PAVEMENT RESTORATION			
APPROVED:	DATE:		DWG. NO.
<i>[Signature]</i>	9/11		9.2-1
CITY OF DUPONT	DRWN:	CHKD:	SCALE:
	L.G.	T.N.	NO SCALE

DATUM
[X] NGVD 29
[] NAVD 88
[] DATUM UNKNOWN

No.	Date	By	Ckd.	Appr.	Revision
1	2/9/2012	CP	CP	AS	REVISED PER COUNTY COMMENTS
2	3/27/2012	CP	CP	AS	REVISED PER COUNTY COMMENTS
3	4/13/2012	CP	CP	AS	REVISED PER COUNTY COMMENTS
4	8/31/2012	CP	CP	AS	REVISED PER CITY OF DUPONT COMMENTS
5	9/29/2013	CK	CP	CP	PER AS-BUILT REVISIONS.
6	9/06/2013	CK	CP	CP	REVISED PER PIERCE COUNTY COMMENTS

Designed AS
Drawn AJ
Checked AS
Approved DKB
Date 10/17/11

Scale:
Horizontal
1"=50'
Vertical
N/A

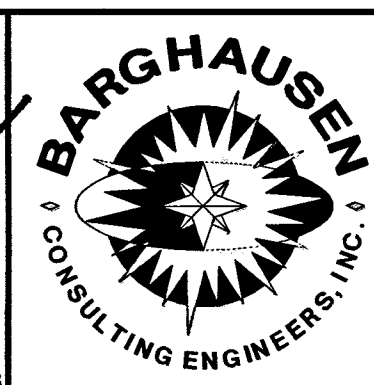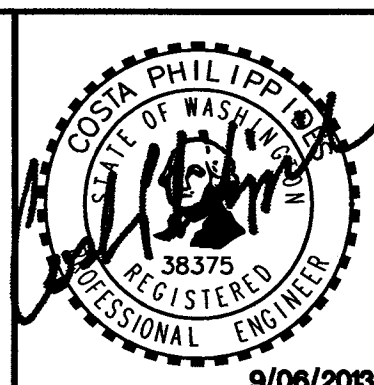

18215 72ND AVENUE SOUTH
KENT, WA 98032
(425)251-6222
(425)251-8782 FAX

CIVIL ENGINEERING, LAND PLANNING,
SURVEYING, ENVIRONMENTAL SERVICES

For:
CREEKSIDE DUPONT PARTNERS, LLC
1201 PACIFIC AVENUE, SUITE 1501
TACOMA, WA 98402
CONTACT: ERIC CEDERSTRAND

Title:
**AS-BUILT
PUBLIC
SANITARY SEWER EXTENSION
PLAN AND PROFILE
CREEKSIDE VILLAGE**

Job Number
14464
Sheet
2 of 2

PER AS-BUILT REVISIONS 08/29/13

File:P:\140003\14464\asbuilt\14464-s2-2.dwg Date/Time:9/6/2013 3:12 PM Scale:1" = 1' C:\PHILIPPS Xref: ---

721730-002