



# CENTER DRIVE TRUCK TURN EXHIBIT

FOR

## DUPONT - WEST

Received 4-23-2024

A PORTION OF THE NW 1/4 OF SECTION 26, TOWNSHIP 19N, RANGE 01E, W.M.  
CITY OF DUPONT, PIERCE COUNTY, WASHINGTON

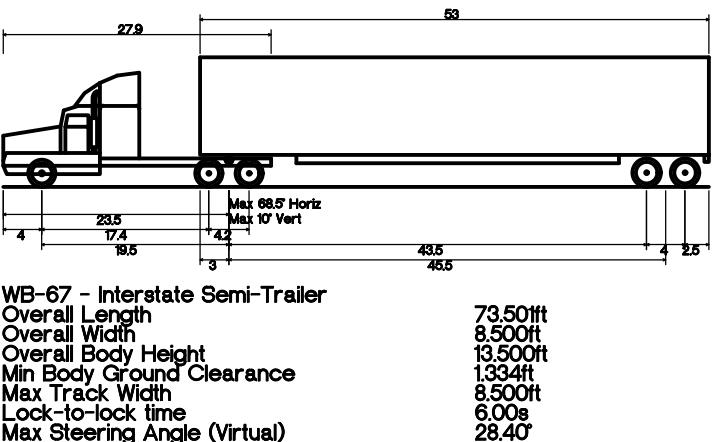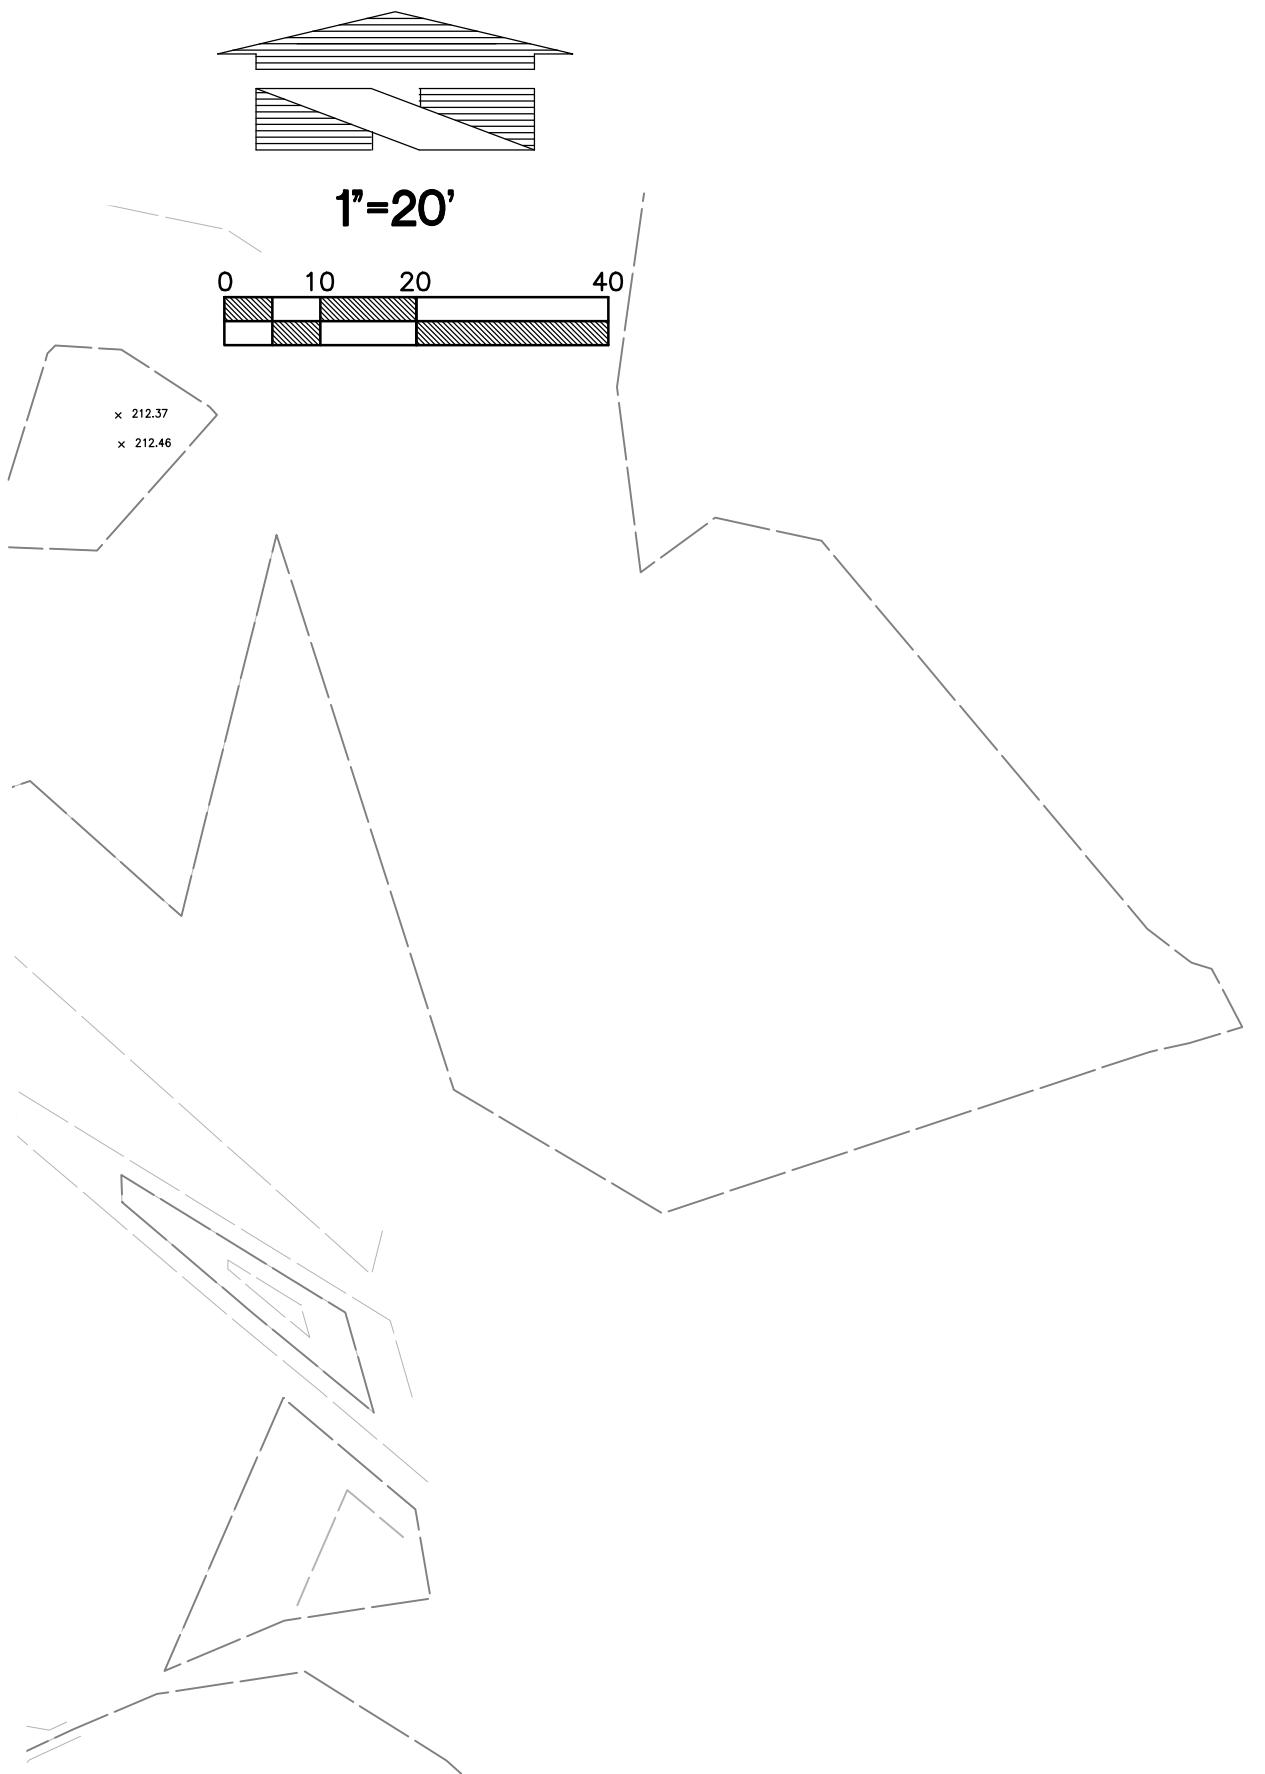

35' LANDSCAPE ESMT  
AFN 9112230168

35' LANDSCAPE, ACCESS  
& UTILITY EASEMENT  
AFN 9601090362

AS-BUILT LOCATION  
TRAIL EASEMENT  
A.F.N. 200906040666

REMOVE EXISTING MEDIAN IN AREA OF  
CONFLICT WITH TRUCK TURNING MOVEMENT

NEW CURB LINE


FOUND 5/8" REBAR/CAP  
"ESM LS 29294/29281"

OPEN SPACE  
AFN 200607251019

FOUND 5/8" REBAR/CAP  
"ESM LS 29294/29281"

Revision  
No. Date By Cld. Appr.  
CENTER DRIVE  
TRUCK TURNING EXHIBIT  
FOR  
DUPONT - WEST

Title:  
CENTER DRIVE  
TRUCK TURNING EXHIBIT  
FOR  
DUPONT - WEST  
No. Date By Cld. Appr.  
Avenue 55, LLC  
601 UNION STREET, SUITE 2930  
SEATTLE, WA 98101  
(206) 707-9696

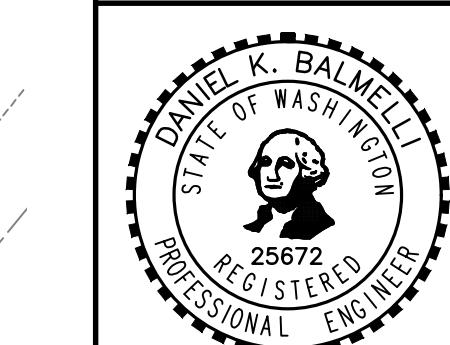

|   |  |   |   |   |   |
|---|--|---|---|---|---|
| Job Number  | 18666  | For:  | AVENUE 55, LLC<br>601 UNION STREET, SUITE 2930<br>SEATTLE, WA 98101<br>(206) 707-9696 | Scale:  | Horizontal<br>1"=20'<br>Vertical<br>N/A   |
| 18215 72ND AVENUE SOUTH<br>KENT, WA 98032<br>(425) 251-6222<br>(425) 251-8782 FAX | Designed JAT<br>Down JAT<br>Checked DKB<br>Approved DKB<br>Date 04/18/24 | 18215 72ND AVENUE SOUTH<br>KENT, WA 98032<br>(425) 251-6222<br>(425) 251-8782 FAX | CIVIL ENGINEERING, LAND PLANNING,<br>SURVEYING, ENVIRONMENTAL SERVICES                | 18215 72ND AVENUE SOUTH<br>KENT, WA 98032<br>(425) 251-6222<br>(425) 251-8782 FAX | 18215 72ND AVENUE SOUTH<br>KENT, WA 98032<br>(425) 251-6222<br>(425) 251-8782 FAX |

