



CENTER DRIVE TRUCK TURN EXHIBIT

FOR

DUPONT - WEST

Received 6-20-2024

A PORTION OF THE NW 1/4 OF SECTION 26, TOWNSHIP 19N, RANGE 01E, W.M.
CITY OF DUPONT, PIERCE COUNTY, WASHINGTON

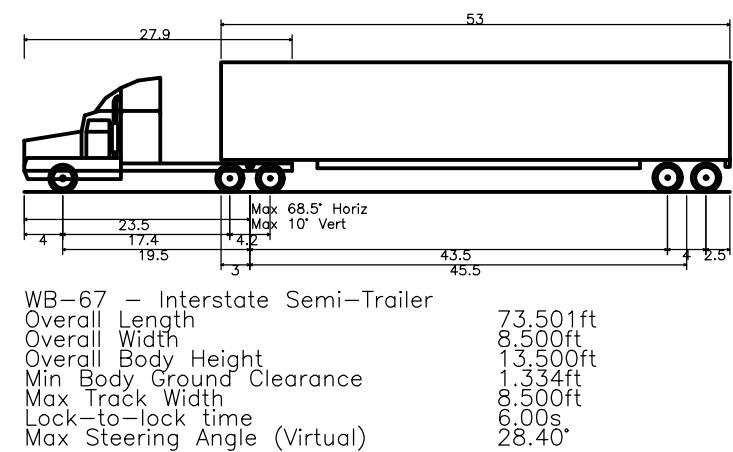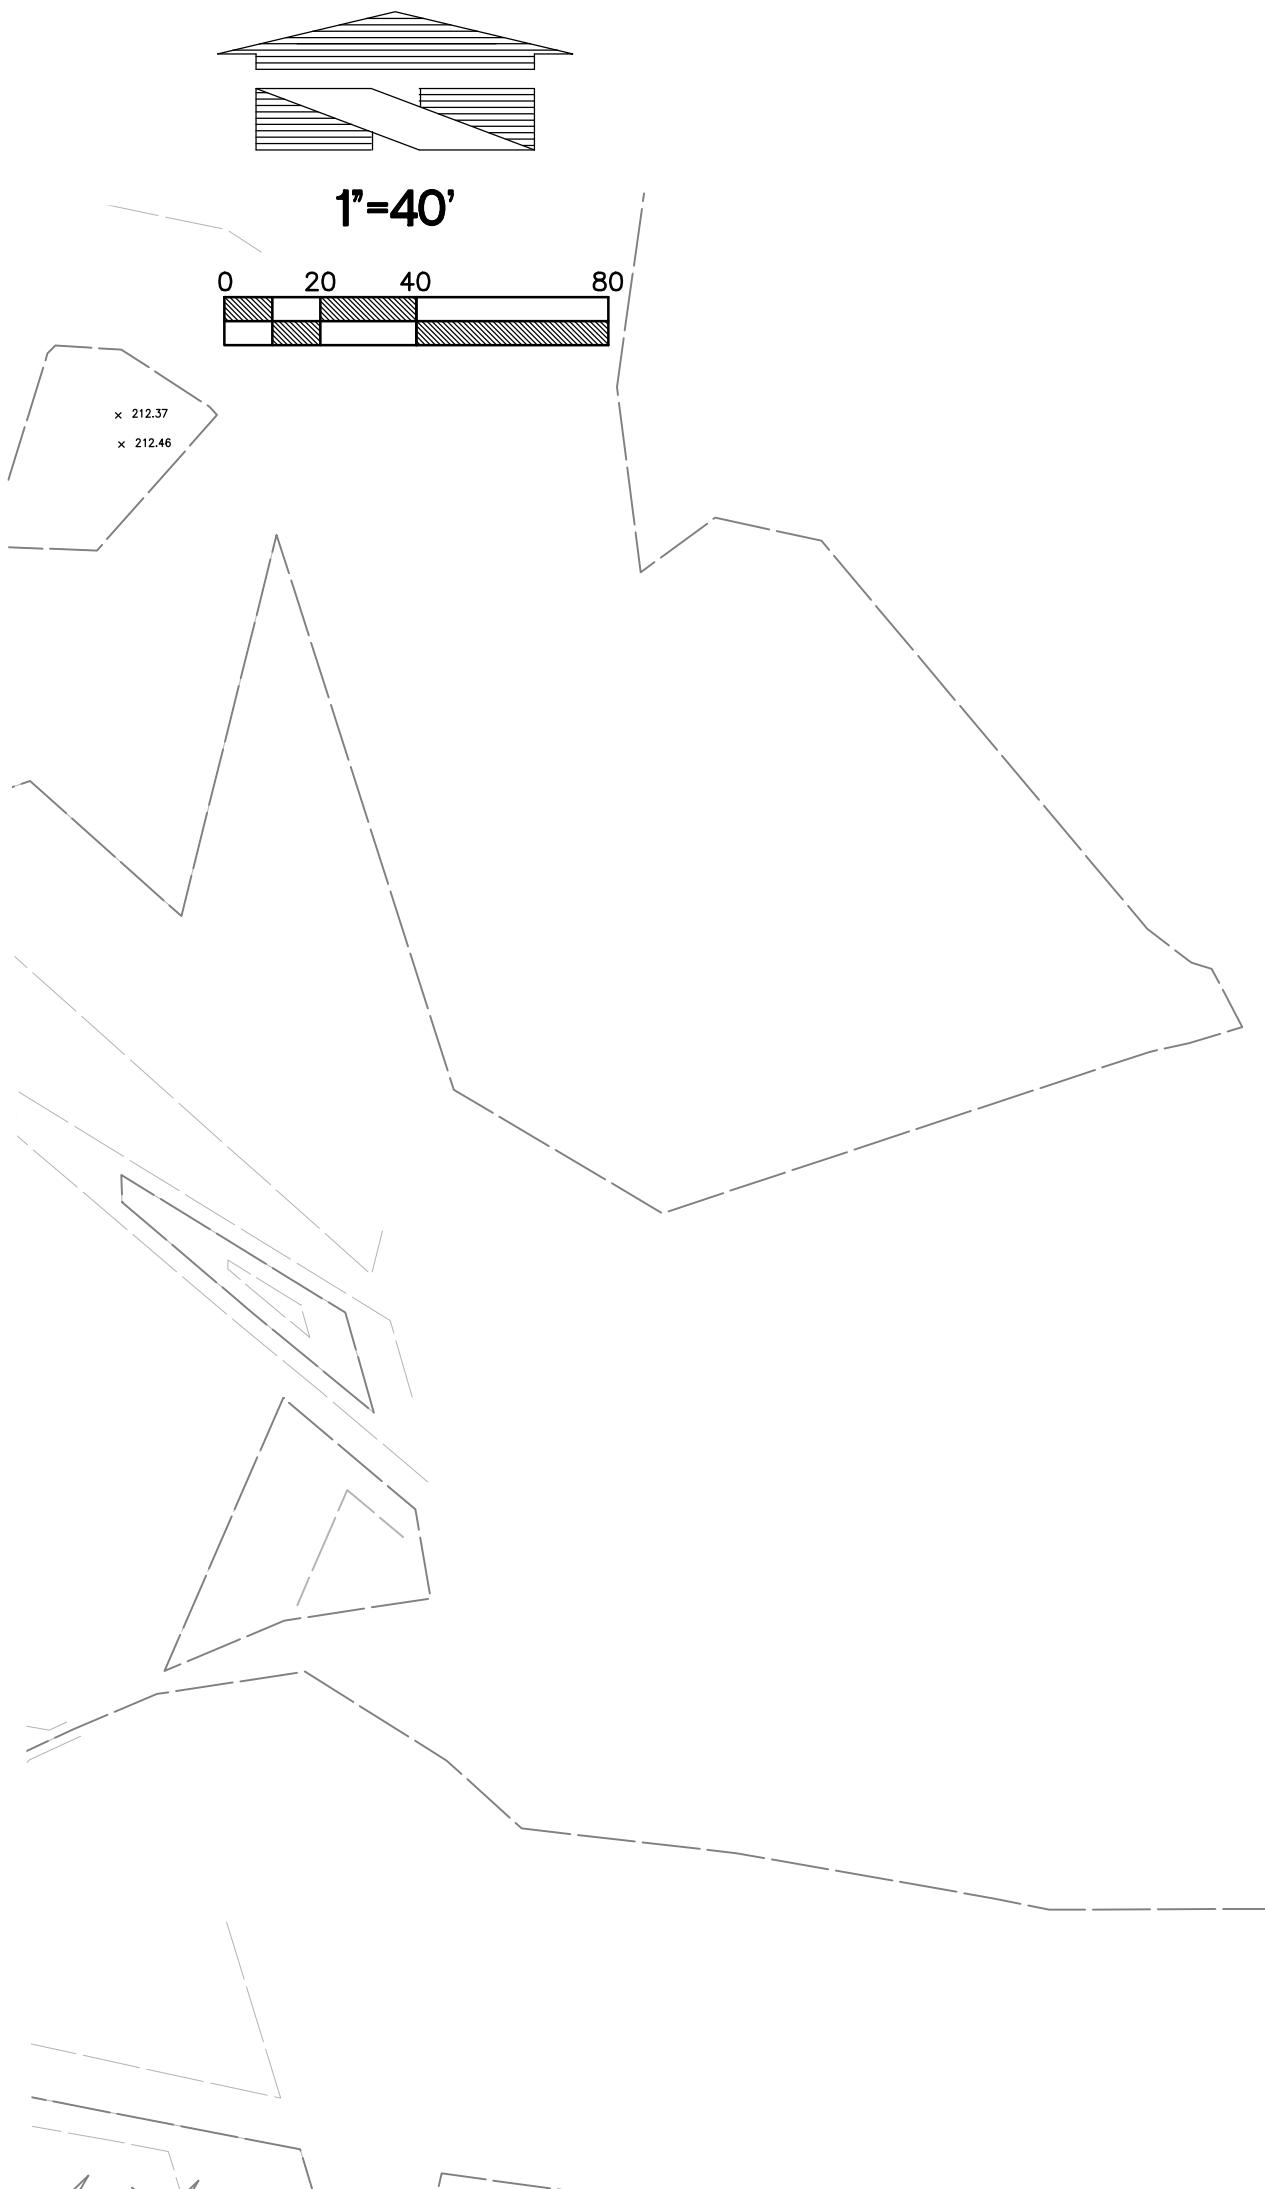

35' LANDSCAPE ESM^T
AFN 9112230168

35' LANDSCAPE, ACCESS
& UTILITY EASEMENT
AFN 9601090362

AS-BUILT LOCATION
TRAIL EASEMENT
A.F.N. 200906040666

REMOVE EXISTING MEDIAN IN AREA OF
CONFLICT WITH TRUCK TURNING MOVEMENT

NEW CURB LINE

NEW SOLID DOUBLE YELLOW LINE

SEQUALITCHEW ROAD

FOUND 5/8" REBAR/CAP
"ESM LS 29294/29281"

OPEN SPACE
AFN 200607251019

FOUND 5/8" REBAR/CAP
"ESM LS 29294/29281"

CENTER DRIVE

CENTER DRIVE TRUCK TURNING EXHIBIT FOR DUPONT - WEST		Revision	
Title:		No. Date By Cld. Appr.	
Avenue 55, LLC 601 Union Street, Suite 2930 Seattle, WA 98101 (206) 707-9696		For:	601 UNION STREET, SUITE 2930 SEATTLE, WA 98101 (206) 707-9696
		Scale: 1"=40' N/A	1"=40' N/A
182-15 72ND AVENUE SOUTH KENT, WA 98032 (425) 251-6222 (425) 251-8782 FAX	Designed JAT Drawn JAT Checked DKB Approved DKB Date 06/18/24	182-15 72ND AVENUE SOUTH KENT, WA 98032 (425) 251-6222 CIVIL ENGINEERING, LAND PLANNING, SURVEYING, ENVIRONMENTAL SERVICES	1"=40' N/A
18666	1 of 1	Job Number	18666
File:\18666\18666\exhibit\18666\TruckTurn-2024-06-13.dwg Date/Time: 5/18/2024 10:57 AM Scale: 1"=40'			



CENTER DRIVE LEFT TURN EXHIBIT

FOR

DUPONT - WEST

Received 6-20-2024

A PORTION OF THE NW 1/4 OF SECTION 26, TOWNSHIP 19N, RANGE 01E, W.M.
CITY OF DUPONT, PIERCE COUNTY, WASHINGTON

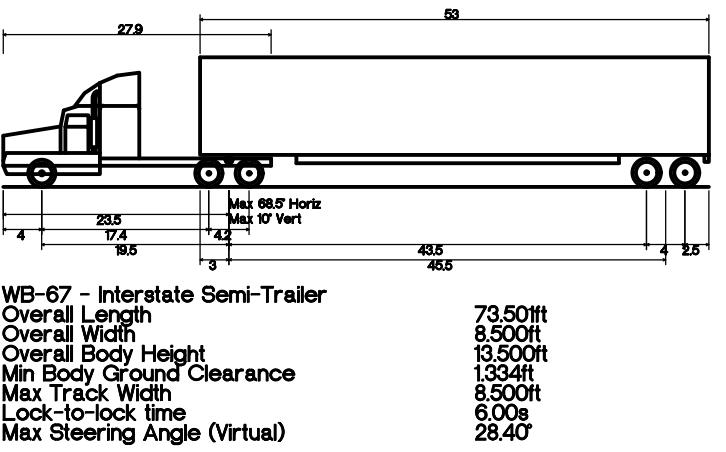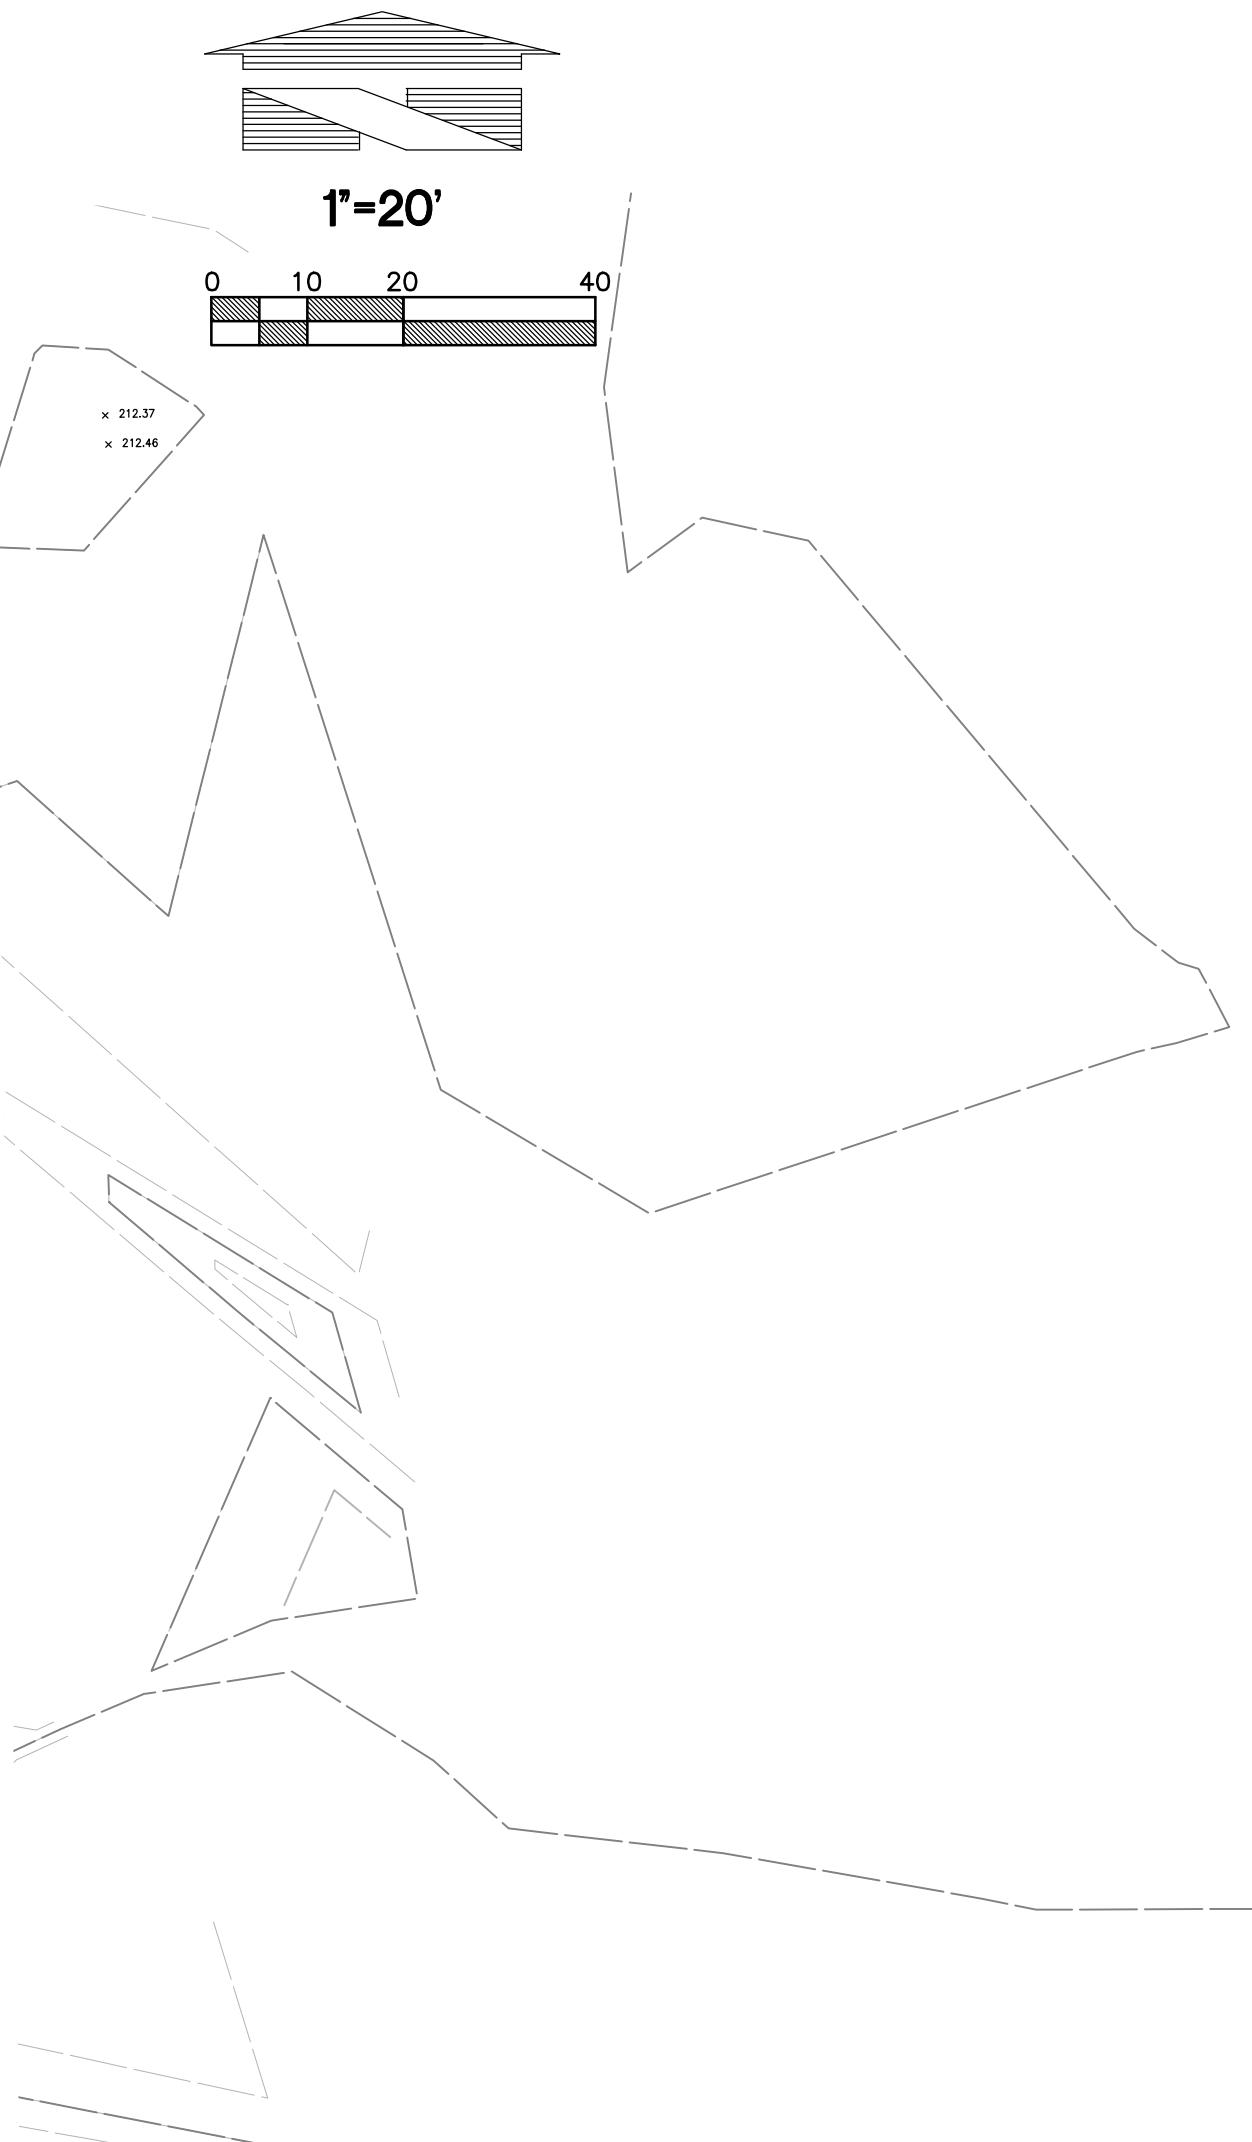

CENTER DRIVE

AS-BUILT LOCATION
TRAIL EASEMENT
A.F.N. 200906040666

REMOVE EXISTING MEDIAN IN AREA OF
CONFLICT WITH TRUCK TURNING MOVEMENT

NEW CURB LINE

NEW SOLID DOUBLE YELLOW LINE

SEQUALITCHEW ROAD


FOUND 5/8" REBAR/CAP
"ESM LS 29294/29281"

OPEN SPACE
AFN 200607251019

FOUND 5/8" REBAR/CAP
"ESM LS 29294/29281"

Revision
No. Date By Cld. Appr.
CENTER DRIVE
LEFT TURN EXHIBIT
FOR
DUPONT - WEST

Title:
Avenue 55, LLC
601 Union Street, Suite 2930
Seattle, WA 98101
(206) 707-9696

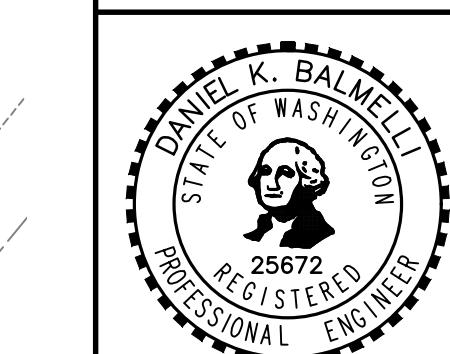

Job Number
18666
Sheet
1 of 1
File:\18666\exhibit\18666\TruckTurn-2024-06-18_left.dwg Date/Time\18/2024 05:55 AM Scale:1:1